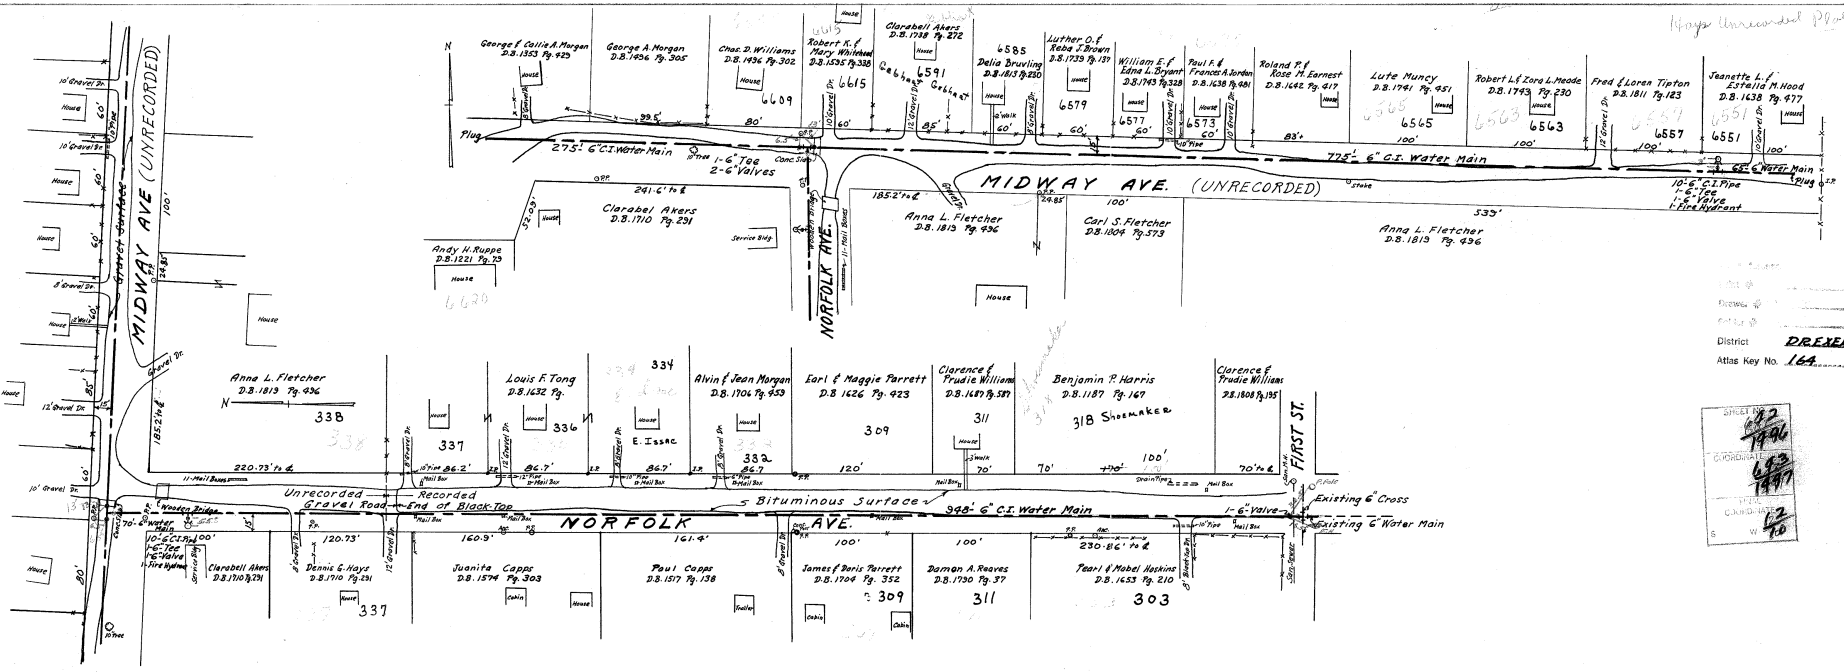

District DREXEL

Atlas Key No. 164

164-010

164-010

DREXEL SEWER DISTRICT

MONTGOMERY COUNTY, OHIO.

WATER DISTRIBUTION

NORFOLK & MIDWAY AVES. NORTH FROM FIRST ST.

SCALE 1" = 50'

E-E SURVEY & ENGINEERING CO.

DAYTON, OHIO. JANUARY, 1957.

By Carl S. Lewis

As Built NOV. 13, 1957

Sheet 2 of 4 Sheets